


1 STREET LEVEL (SOUTH)
REFLECTED CEILING PLAN
SCALE: 1/8"=1'-0"

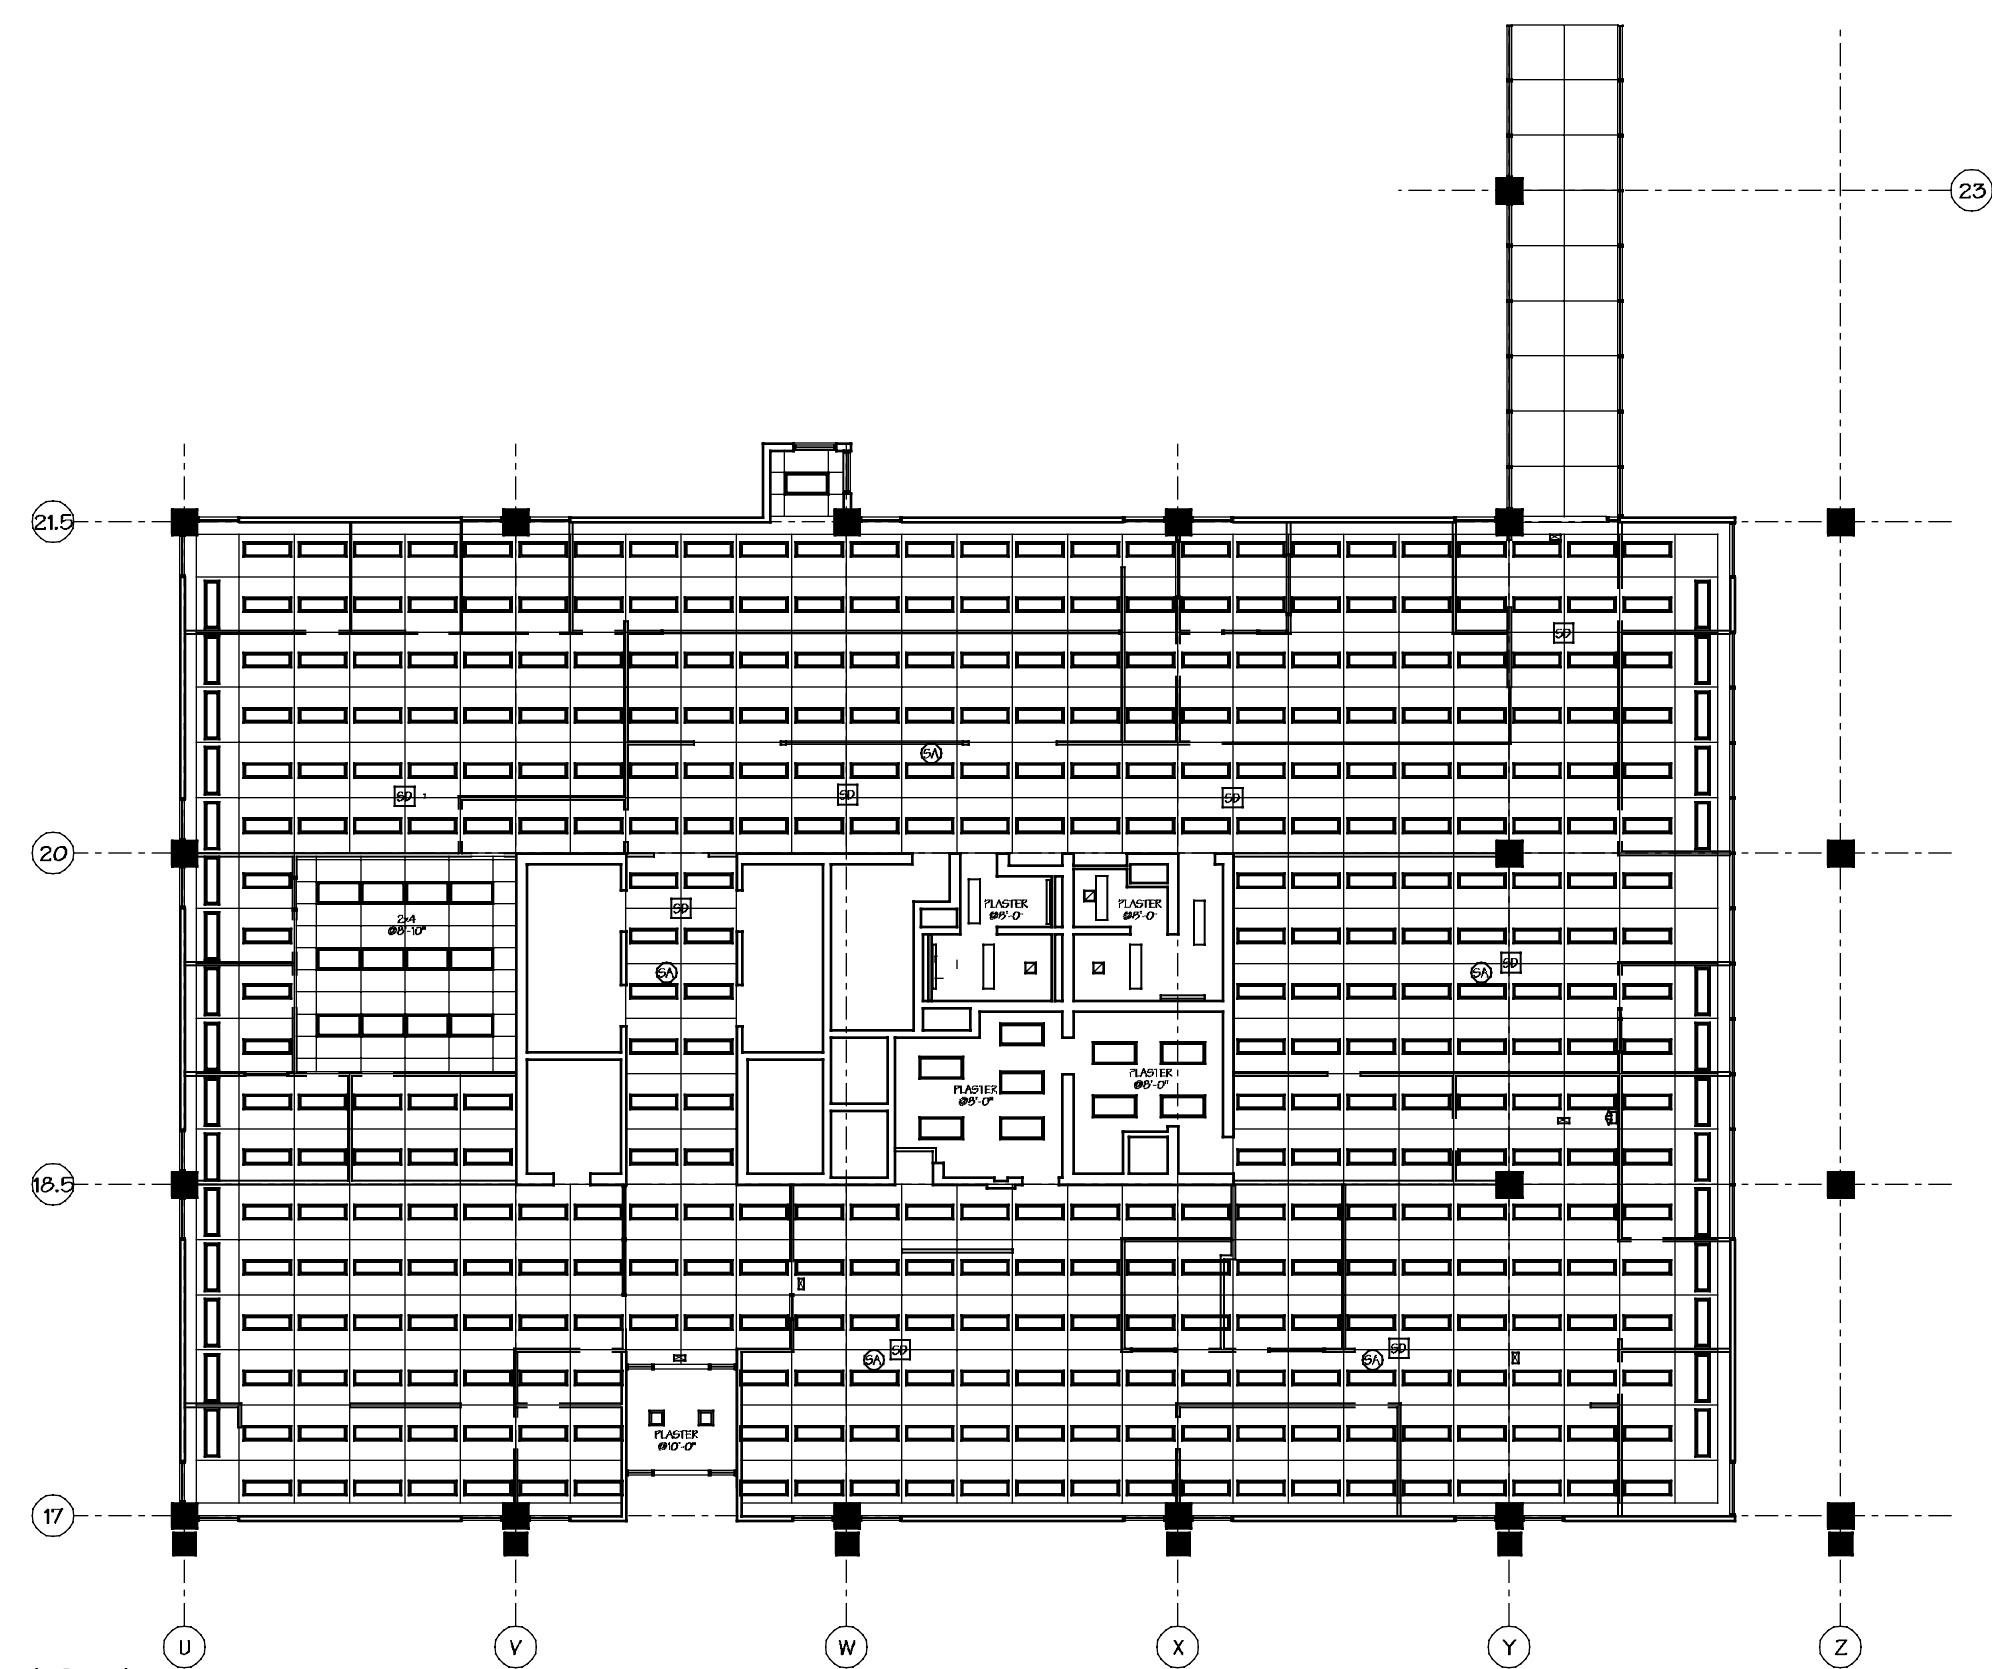

AS-BUILT SURVEY
**TULSA CIVIC
CENTER COMPLEX**
CITY OF TULSA, OKLAHOMA

CITY HALL BUILDING	
STREET LEVEL (SOUTH) REFLECTED CEILING PLAN	
Drawn By:	DM
Checked By:	JM
Job Number:	9622.00
Issue Date:	January 31, 1997
Revisions:	
Sheet No:	A3.1

Morrison & Associates
Environmental Design and Management, Inc.
501 Alpine Circle
405/360-5625
Norman, OK 73069
FAX 405/321-0517