


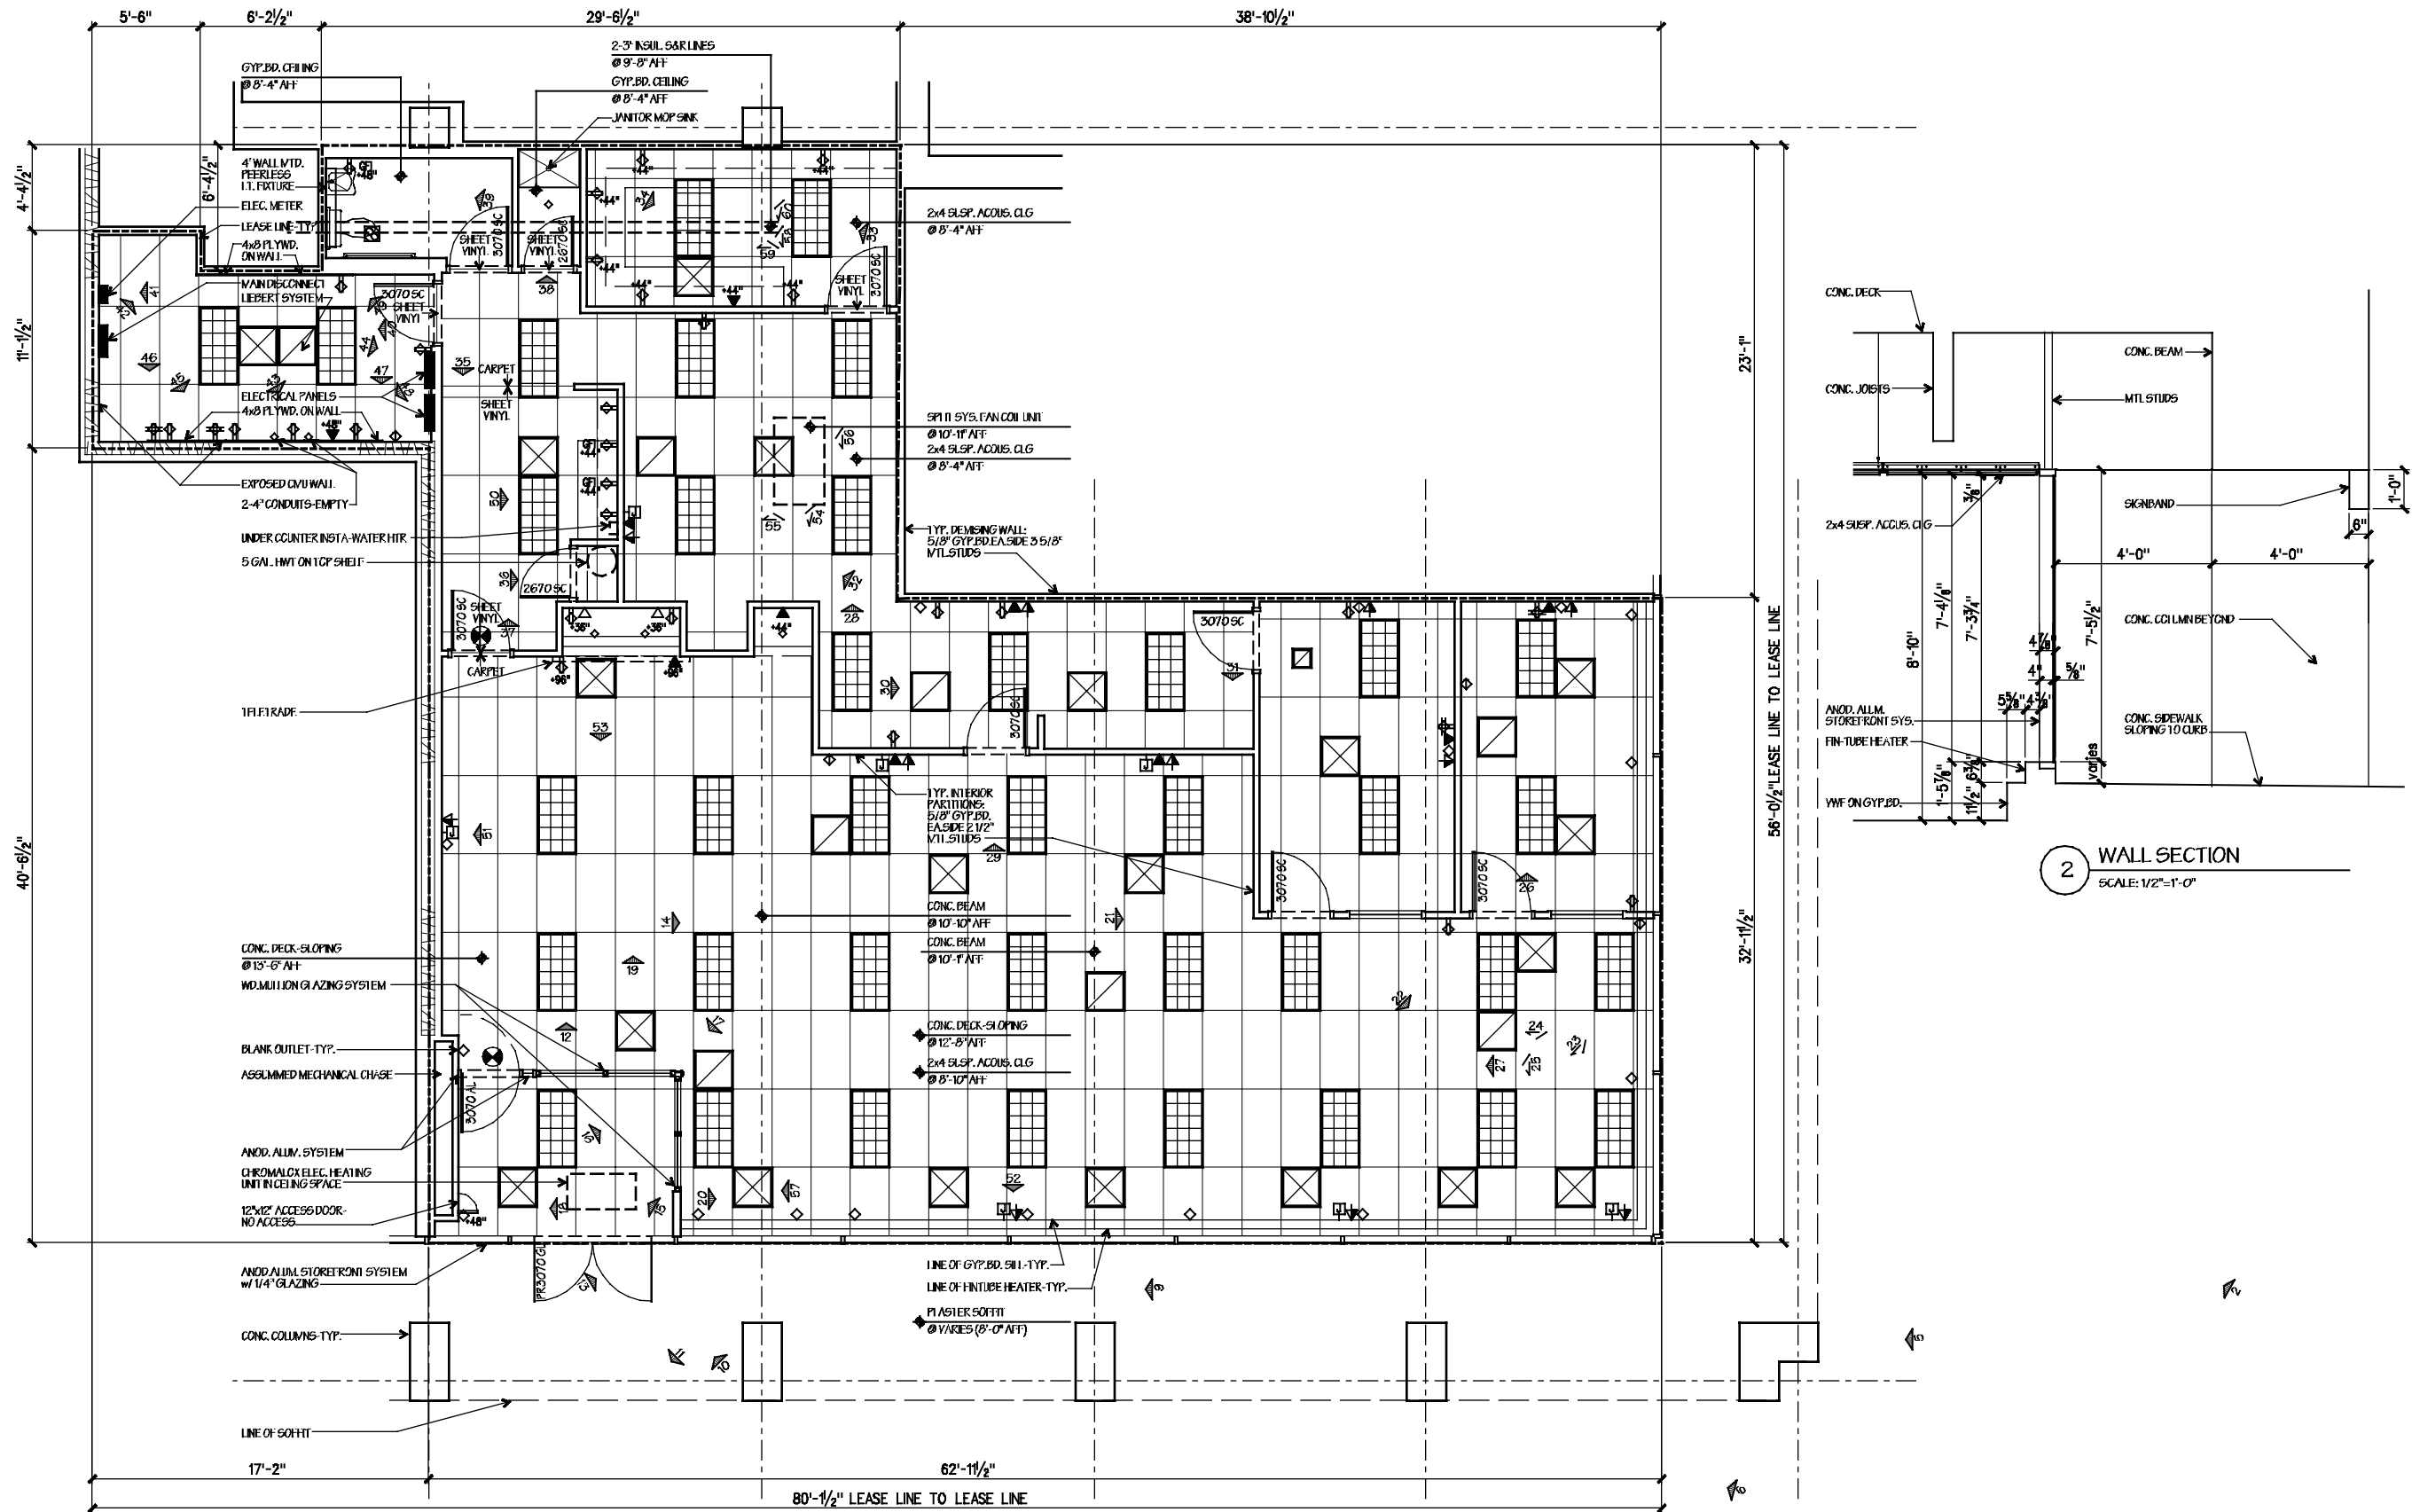

1 SURVEY FLOOR PLAN
SCALE: 1/4"=1'-0"

2 WALL SECTION
SCALE: 1/2"=1'-0"

G&F = 2,830 of

Morrison & Associates
Environmental Design and Management, Inc.
Norman, OK 73069
501 Alpine Circle
405/360-5625
FAX 405/321-0517

CHARLES SCHWAB
BRANCH LOCATION
SURVEY AT
100 Bank Street
Norfolk, VA 23510

ASBUILT SURVEY	
Drawn By:	DM
Checked By:	JM
TGA Number:	9925.05
Job Number:	0005.00
Issue Date:	February 11, 2000
Revisions:	
Sheet No:	A51